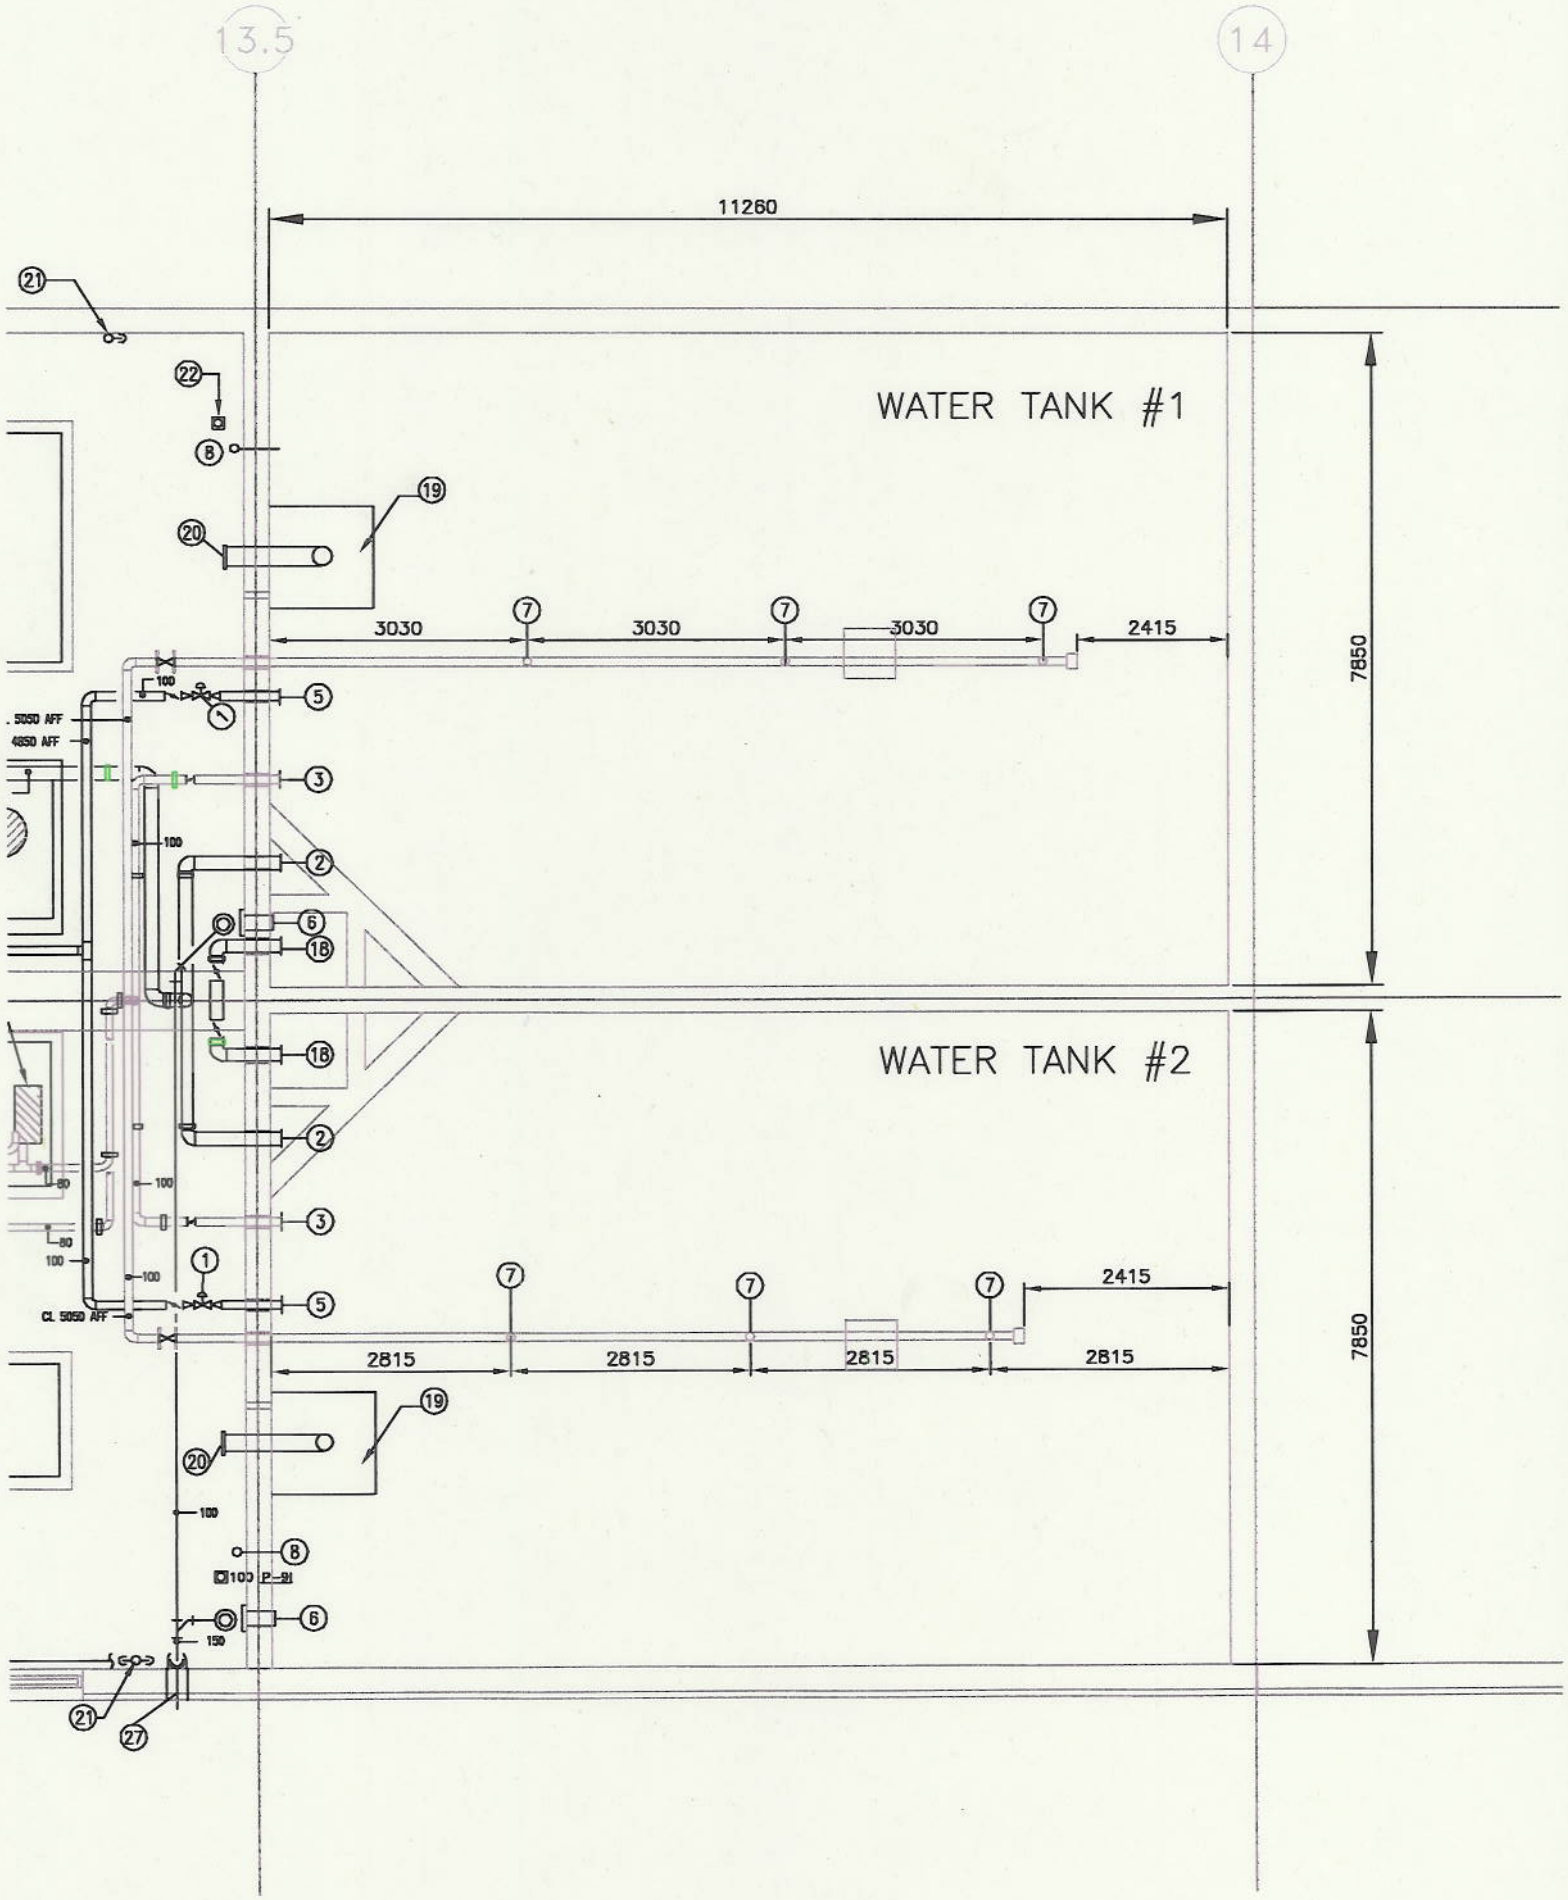
13.5
14
11260
WATER TANK #1
WATER TANK #2
3030
3030
3030
2415
2815
2815
2815
2815
2415
7850
7850
. 5050 AFF
4850 AFF
CL 5050 AFF
100 P-91

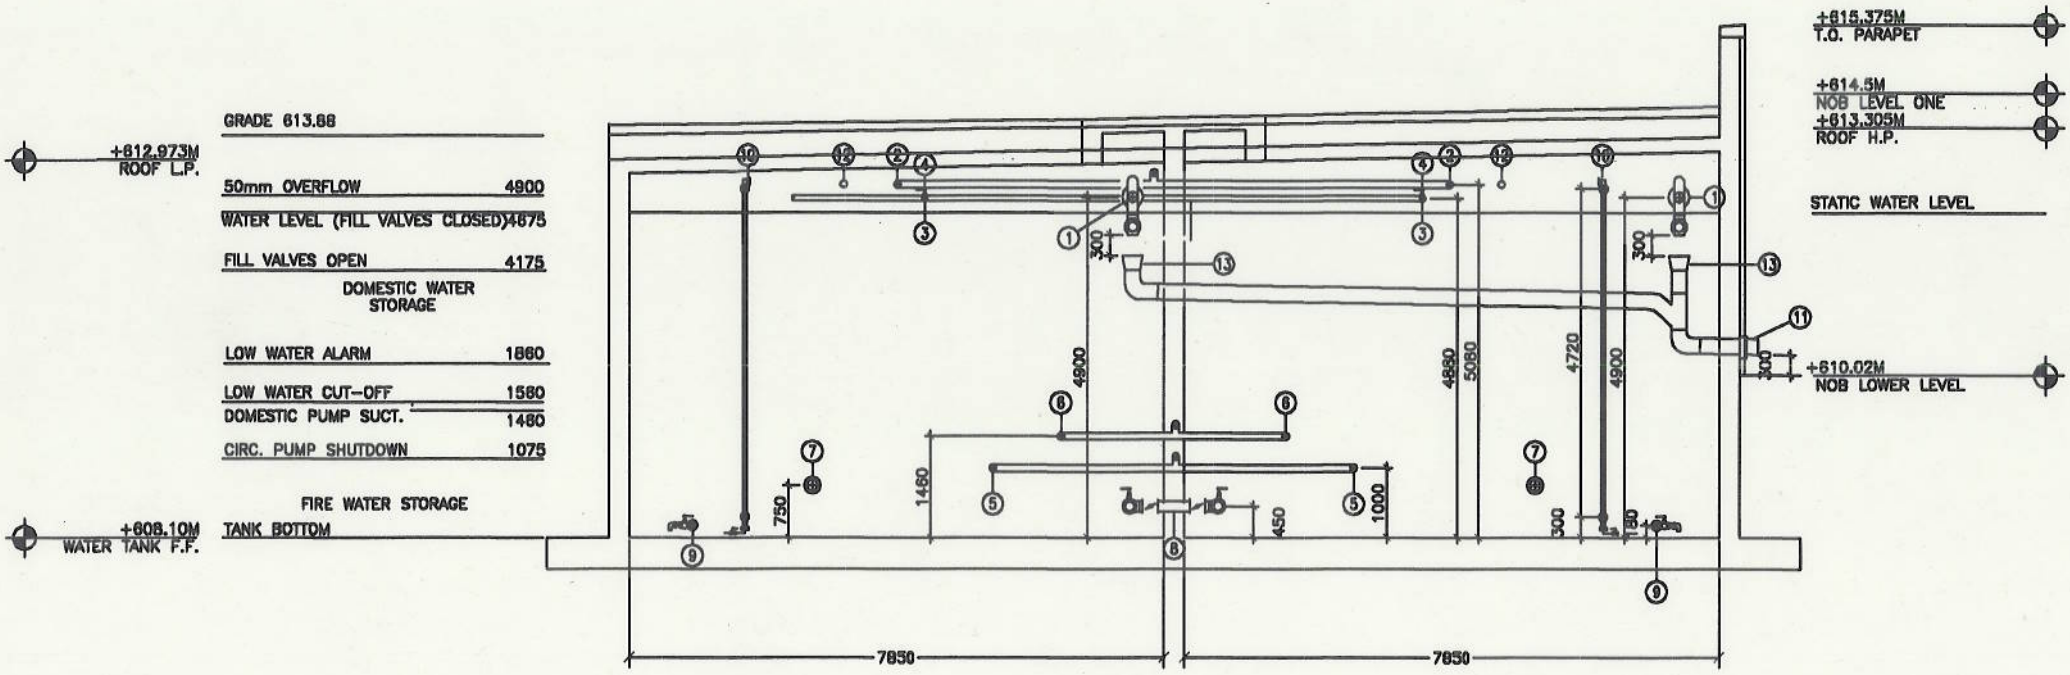
+615.375M
T.O. PARAPET
+614.5M
NOB LEVEL ONE
+613.305M
ROOF H.P.
STATIC WATER LEVEL
+610.02M
NOB LOWER LEVEL
+612.973M
ROOF L.P.
GRADE 613.88
50mm OVERFLOW 4900
WATER LEVEL (FILL VALVES CLOSED)4675
FILL VALVES OPEN 4175
DOMESTIC WATER STORAGE
LOW WATER ALARM 1860
LOW WATER CUT-OFF 1580
DOMESTIC PUMP SUCT. 1480
CIRC. PUMP SHUTDOWN 1075
FIRE WATER STORAGE
+608.10M
WATER TANK F.F.
TANK BOTTOM
7850
7850

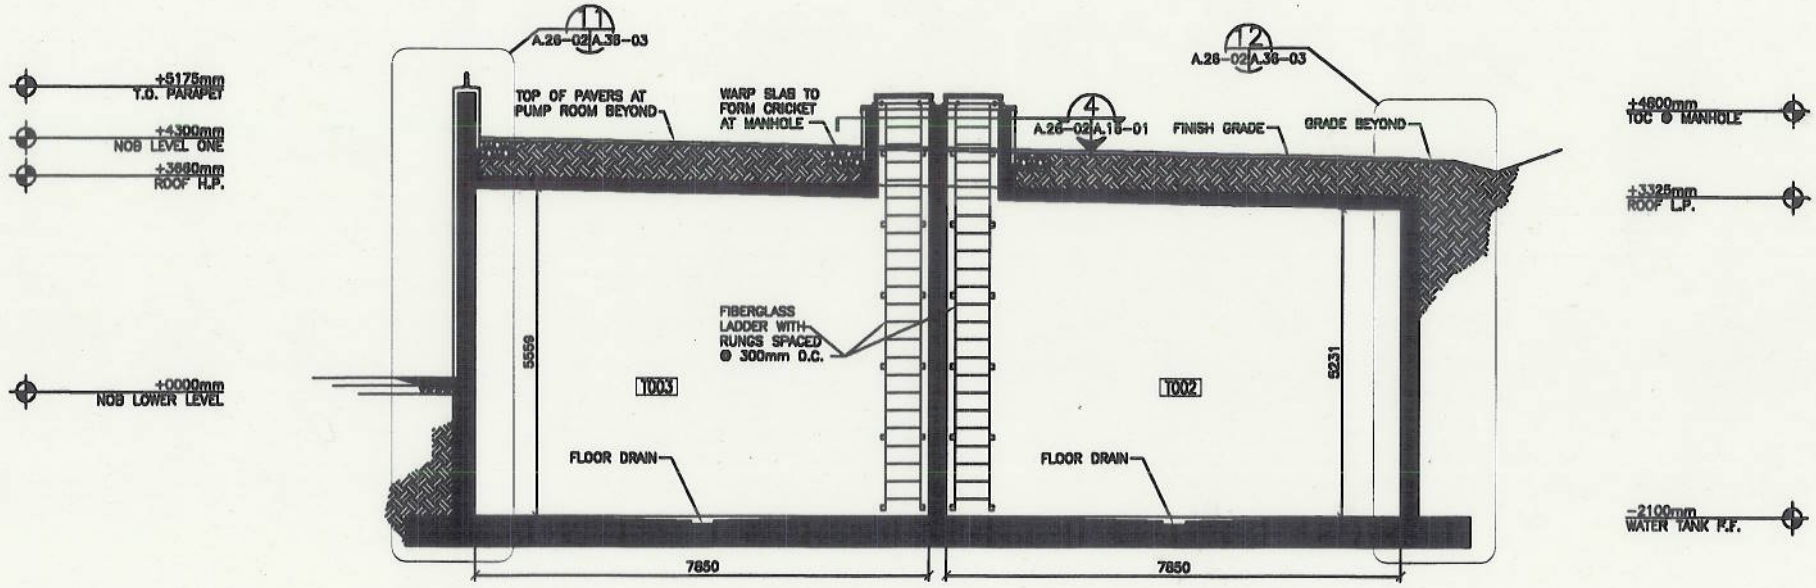

C
A.16-01/A.26-02

PARTIAL SECTION

SCALE 1:50

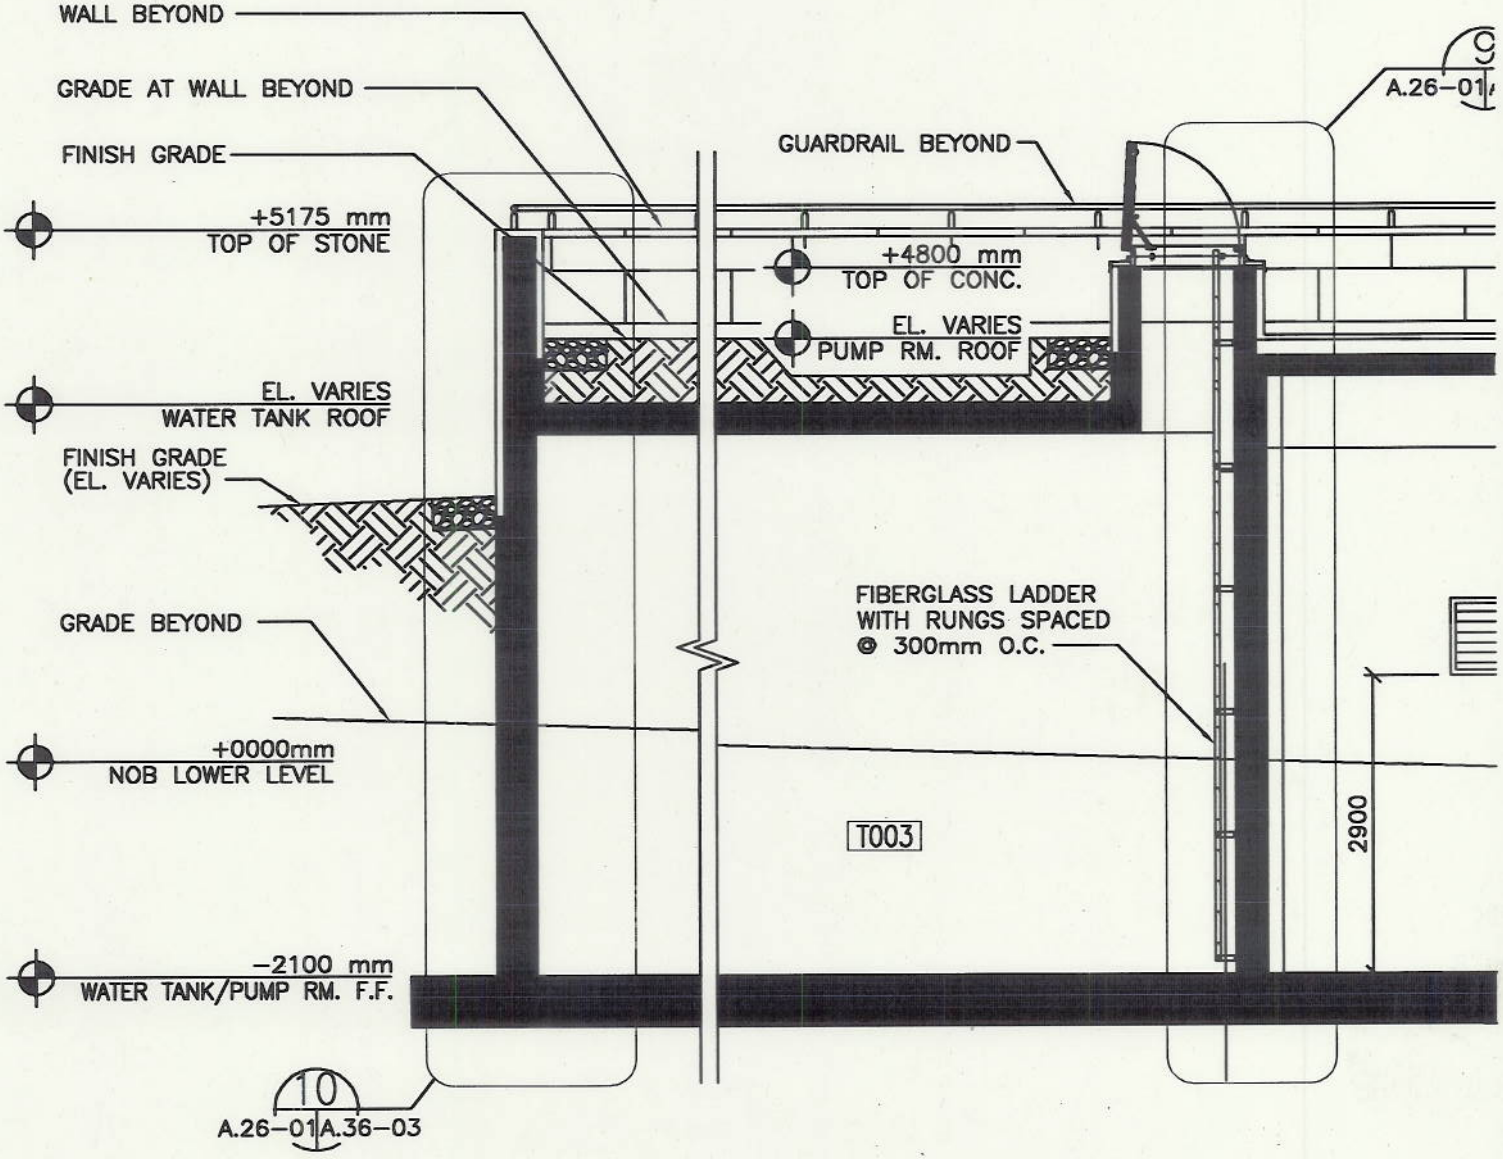

A
A.16-01 A.26-01

PARTIAL SECTION

SCALE 1:50

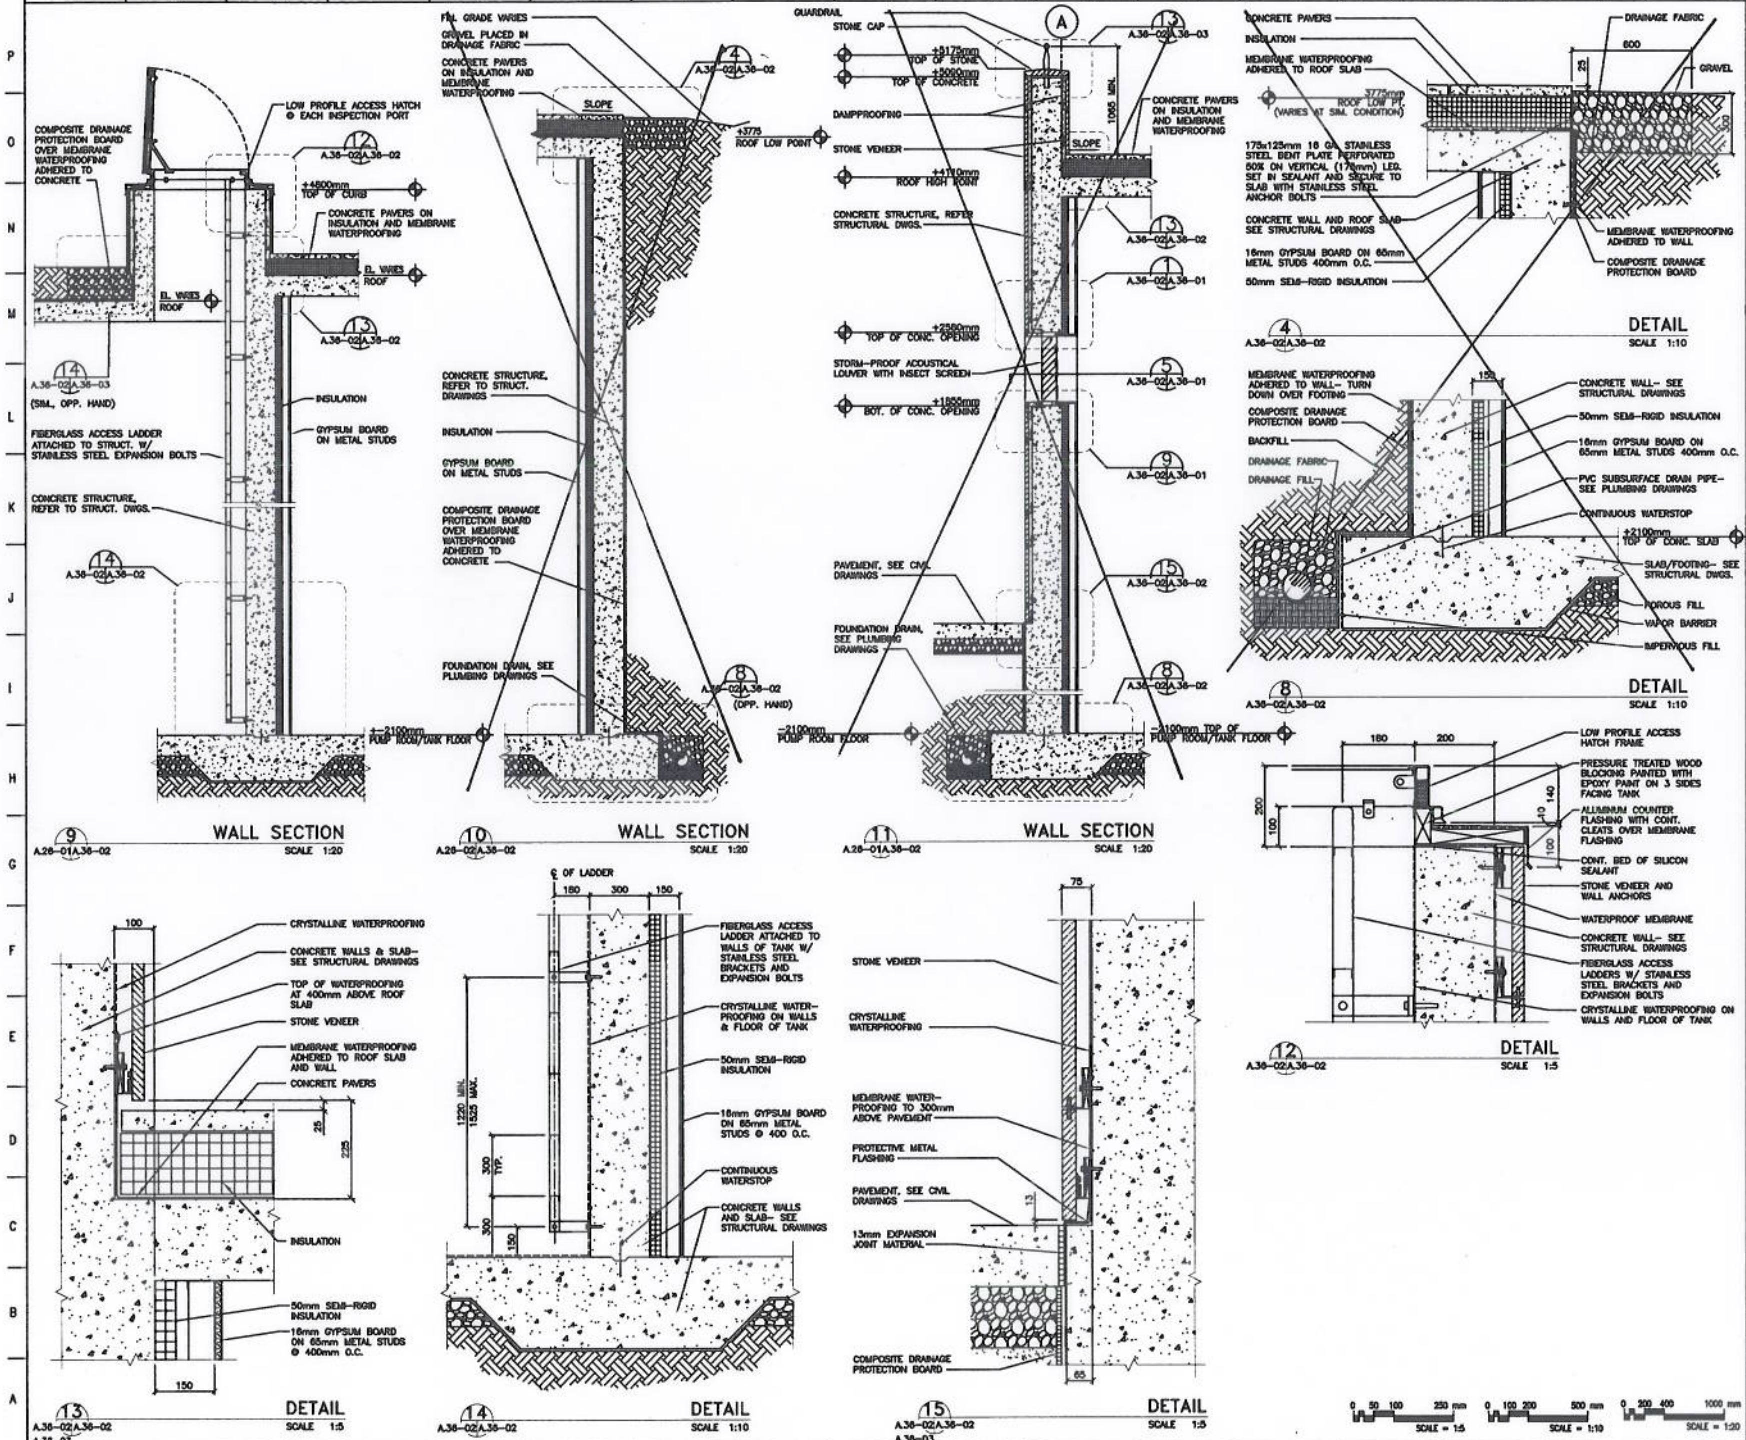

United States Department of State
OVERSEAS BUILDINGS OPERATIONS
Washington, D.C.

SOFIA PROJECT
Sofia, Bulgaria

FINAL CONSTRUCTION DOCUMENTS

DO NOT SCALE DRAWINGS

See As-Built Roofing Shop Drawings for more details
See As-Built Stone Shop Drawings for more details
As-built comments

CONTRACTOR
JA Jones Construction Company
JA Jones Drive
Charlotte, NC 28287
Telephone (704) 553-3000
FAX (704) 553-3309

ENGINEERING
Hellmuth, Obata + Kassabaum, Inc.
2800 Post Oak Blvd.
Suite 3700
Houston, TX 77056
Telephone (713) 407-7700
FAX (713) 407-7809

ARCHITECT
CMSS Architects, P.C.
4505 Columbus Street
Suite 100
Virginia Beach, Virginia 23462
Telephone (757) 222-2010
FAX (757) 222-2022

AS-BUILT

WATER TANKS/PUMP ROOM
WALL SECTIONS

Drawing Scale 1:20
Plot Scale 100%
Date 09/22/03
Drawn by CMSS
Checked by DJE
CMPD A.36-02

UNCLASSIFIED

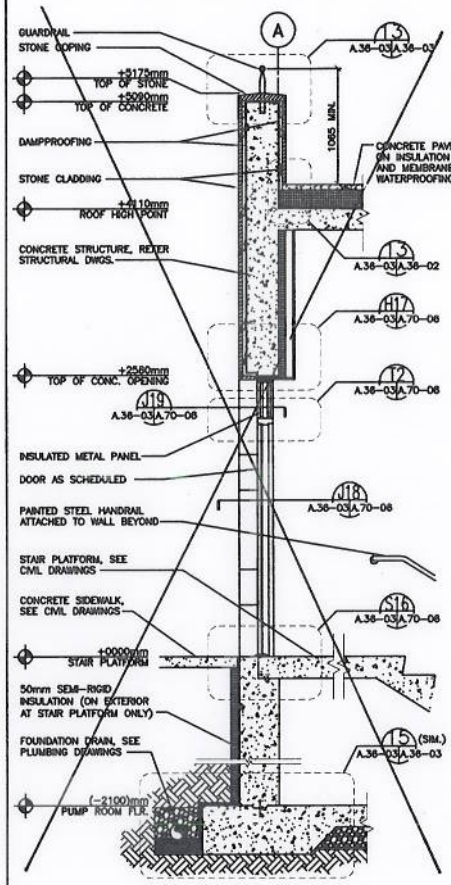

9 A.16-01/A.36-03 WALL SECTION SCALE 1:20

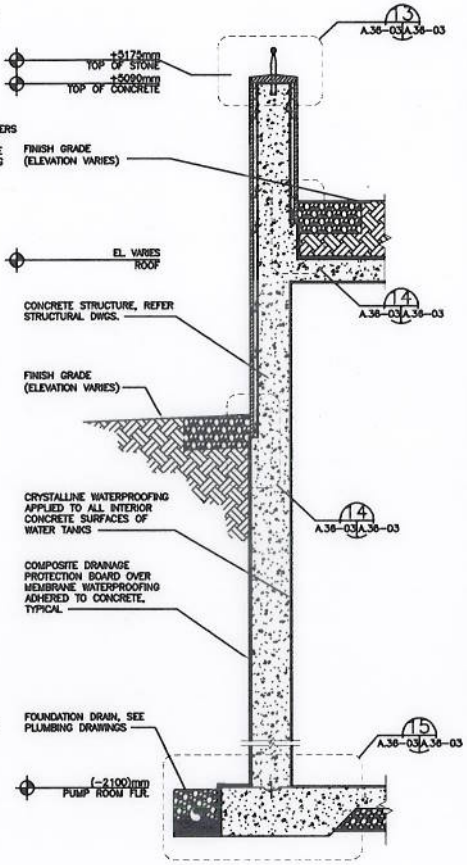

10 A.26-01/A.36-03 WALL SECTION SCALE 1:20

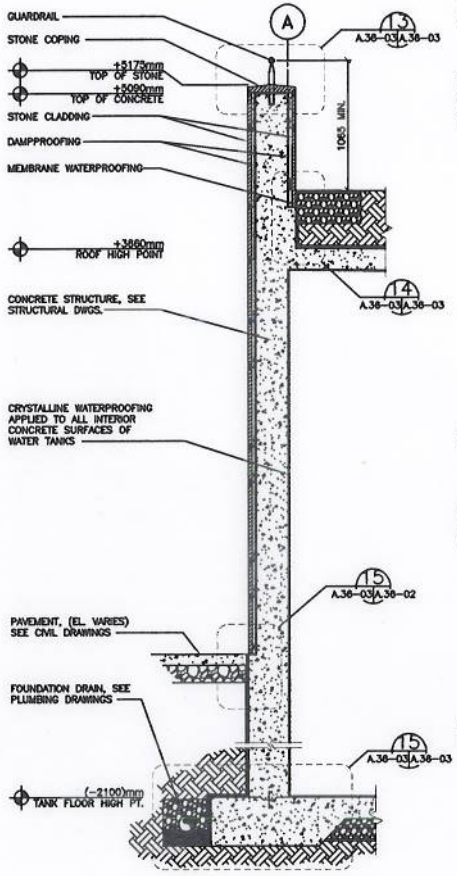

11 A.26-02/A.36-03 WALL SECTION SCALE 1:20

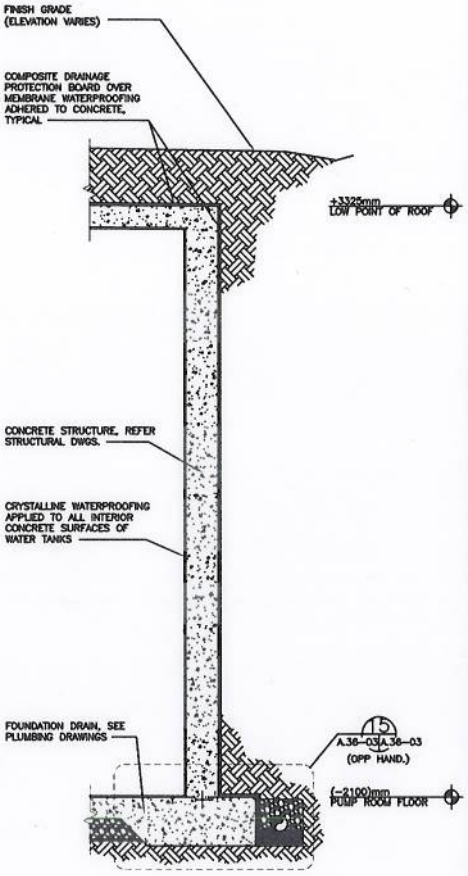

12 A.26-02/A.36-03 WALL SECTION SCALE 1:20

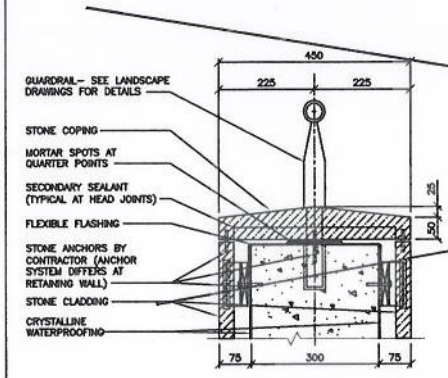

13 A.36-02/A.36-03 DETAIL SCALE 1:5

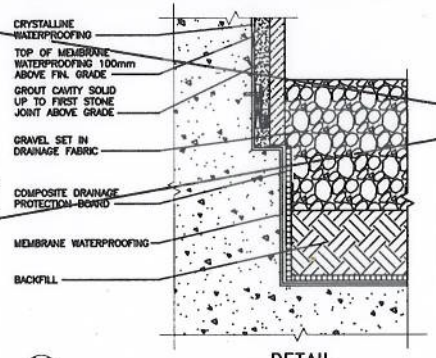

14 A.36-02/A.36-03 DETAIL SCALE 1:5

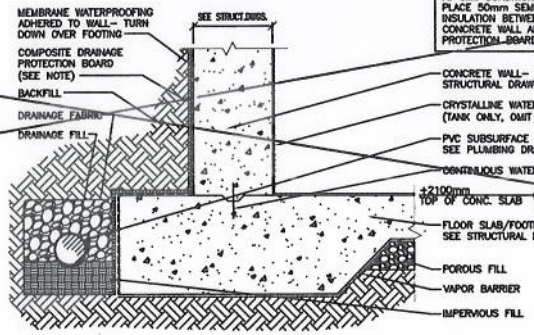

15 A.36-03/A.36-03 DETAIL SCALE 1:10

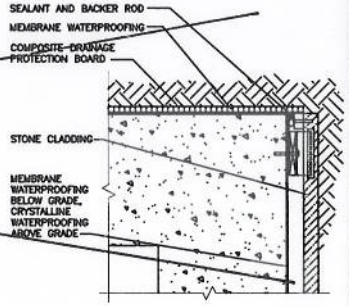

16 A.16-01/A.36-03 DETAIL SCALE 1:5

0 50 100 250 mm SCALE = 1:5 | 0 100 200 500 mm SCALE = 1:10 | 0 200 400 1000 mm SCALE = 1:20

United States Department of State
OVERSEAS BUILDINGS OPERATIONS
Washington, D.C.

SOFIA PROJECT
Sofia, Bulgaria

WARNING: This document is the property of the U.S. Government. Further reproduction and/or distribution is prohibited without express written permission of Overseas Buildings Operations, U.S. Department of State, Washington, D.C. 20521-0108. Information on this document is not to be altered except with the written approval of the individual whose and seeing initials.

J.A. JONES CONSTRUCTION COMPANY WARRANTY DISCLAIMER
Information contained within this electronic document is being transmitted to you on a child cost-to-time basis. By receipt of this information, you have accepted responsibility to control the distribution and dissemination on a child cost-to-time basis. Ultimately, you agree to return these documents or submit a certificate of destruction (burning, shredding, or pulverizing) upon completion of the legitimate purpose.

FINAL CONSTRUCTION DOCUMENTS

DO NOT SCALE DRAWINGS

	See As-built Roofing Shop Drawings for more details
As-b. c.	See As-built Stone Shop Drawings for more details
As-built comments	As-b. c. by Y.I.

CONSTRUCTOR
JA Jones Construction Company
JA Jones Drive
Charlotte, NC 28287
Telephone (704) 553-3000
FAX (704) 553-3399

ENGINEERS
Heilmuth, Obata + Kassabaum, Inc.
2800 Post Oak Blvd.
Suite 3700
Houston, TX 77056
Telephone (713) 407-7700
FAX (713) 407-7809

ARCHITECT
CMSS Architects, P.C.
4605 Columbus Street
Suite 100
Virginia Beach, Virginia 23462
Telephone (757) 222-2010
FAX (757) 222-2022

AS-BUILT

Release For Construction

Drawing Title
WATER TANKS/PUMP ROOM WALL SECTIONS

OBO Project Number S-AMEC-01-C-0031	Drawing Scale AS NOTED
OBO File Name.dwg HOA A C 36-02.DWG	OBO Plot Scale 1.00X
Date 06/22/03	Sheet Number CMPD A.36-03
Drawn By CMSS	
Checked By DJE	
Project Number 01-0575-20	

UNCLASSIFIED